


#2215
VACANT
2355 USF
2727 RSF



THE WESTIN BUILDING
2001 SIXTH LLC

22nd Floor
AS-BUILT FLOOR PLAN
NOT TO SCALE

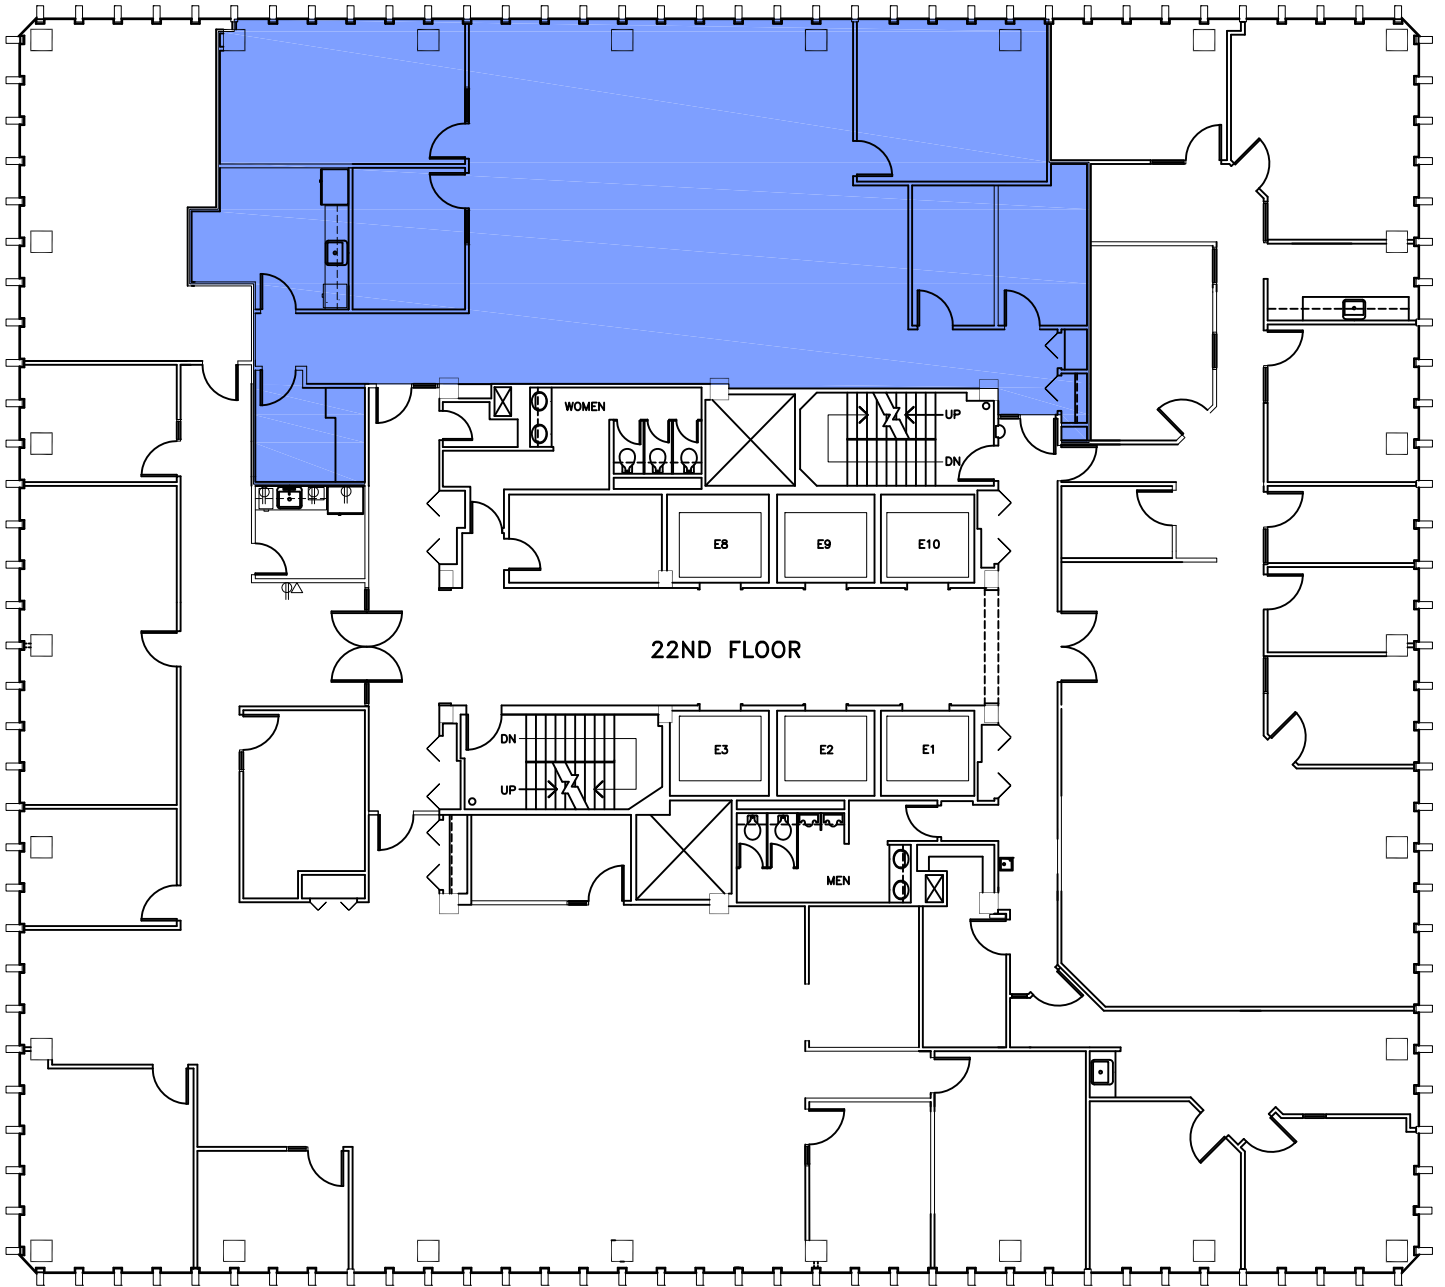