


#2323
AVAILABLE
3548 USF
4098 RSF



23RD FLOOR

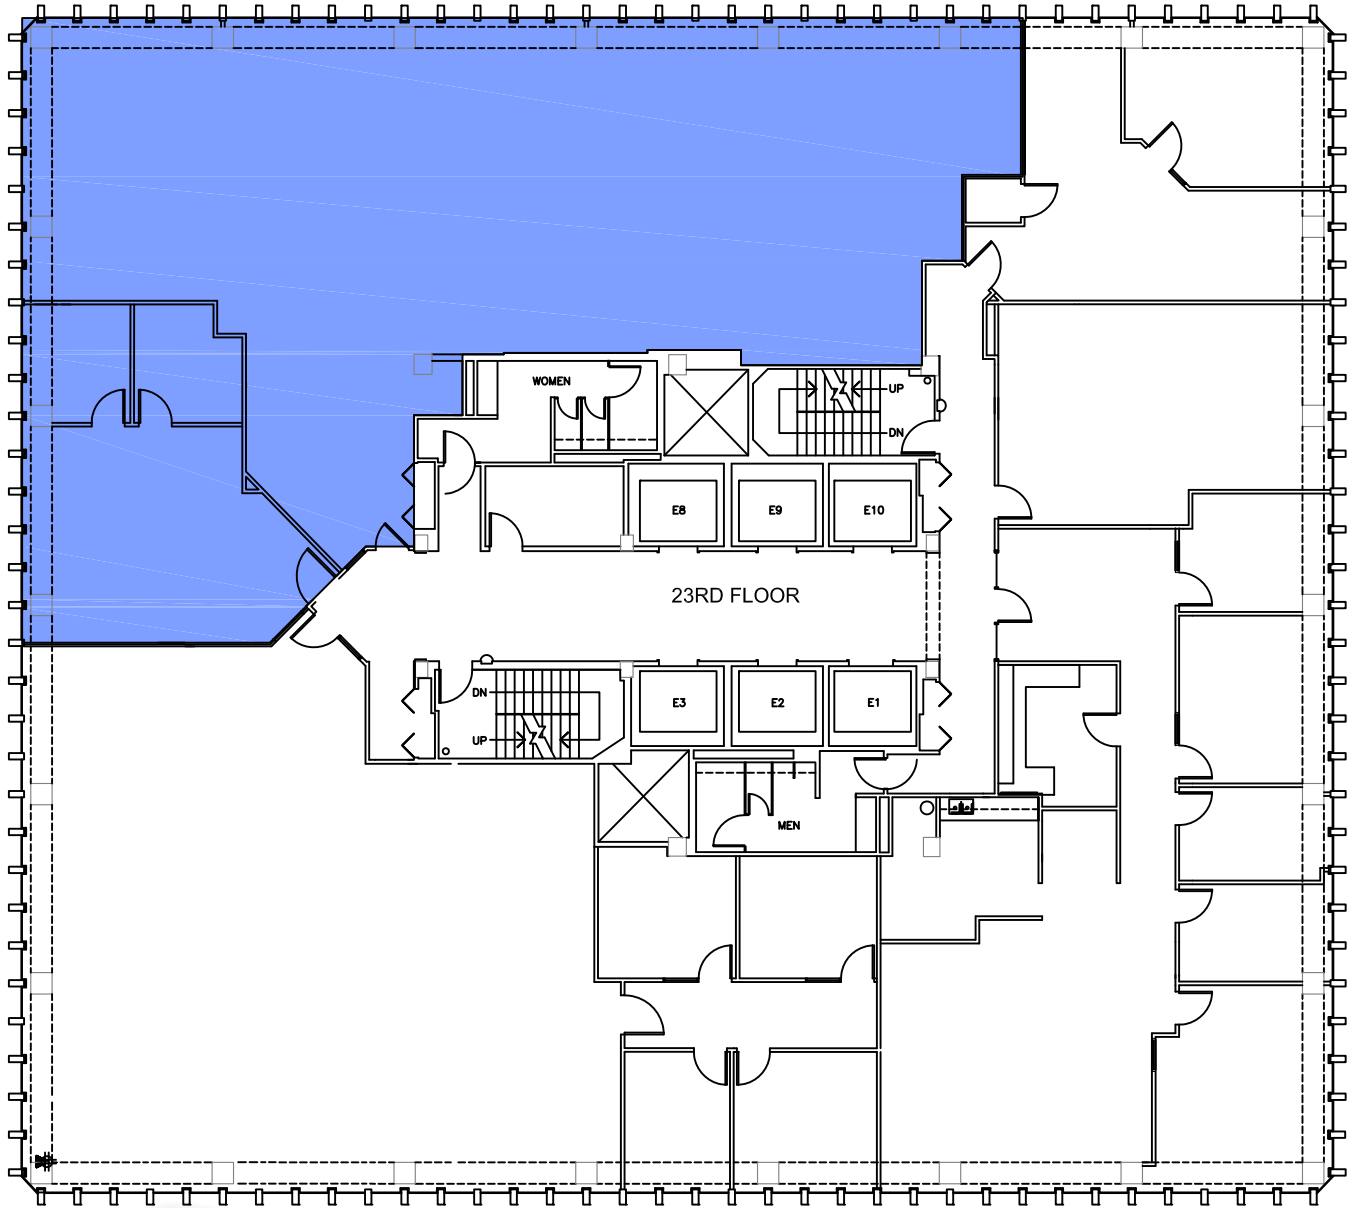

THE WESTIN BUILDING
2001 SIXTH LLC

AS-BUILT FLOOR PLAN
NOT TO SCALE

