


#2420
AVAILABLE
2264 USF
2614 RSF



THE WESTIN BUILDING
2001 SIXTH LLC

AS-BUILT FLOOR PLAN
NOT TO SCALE

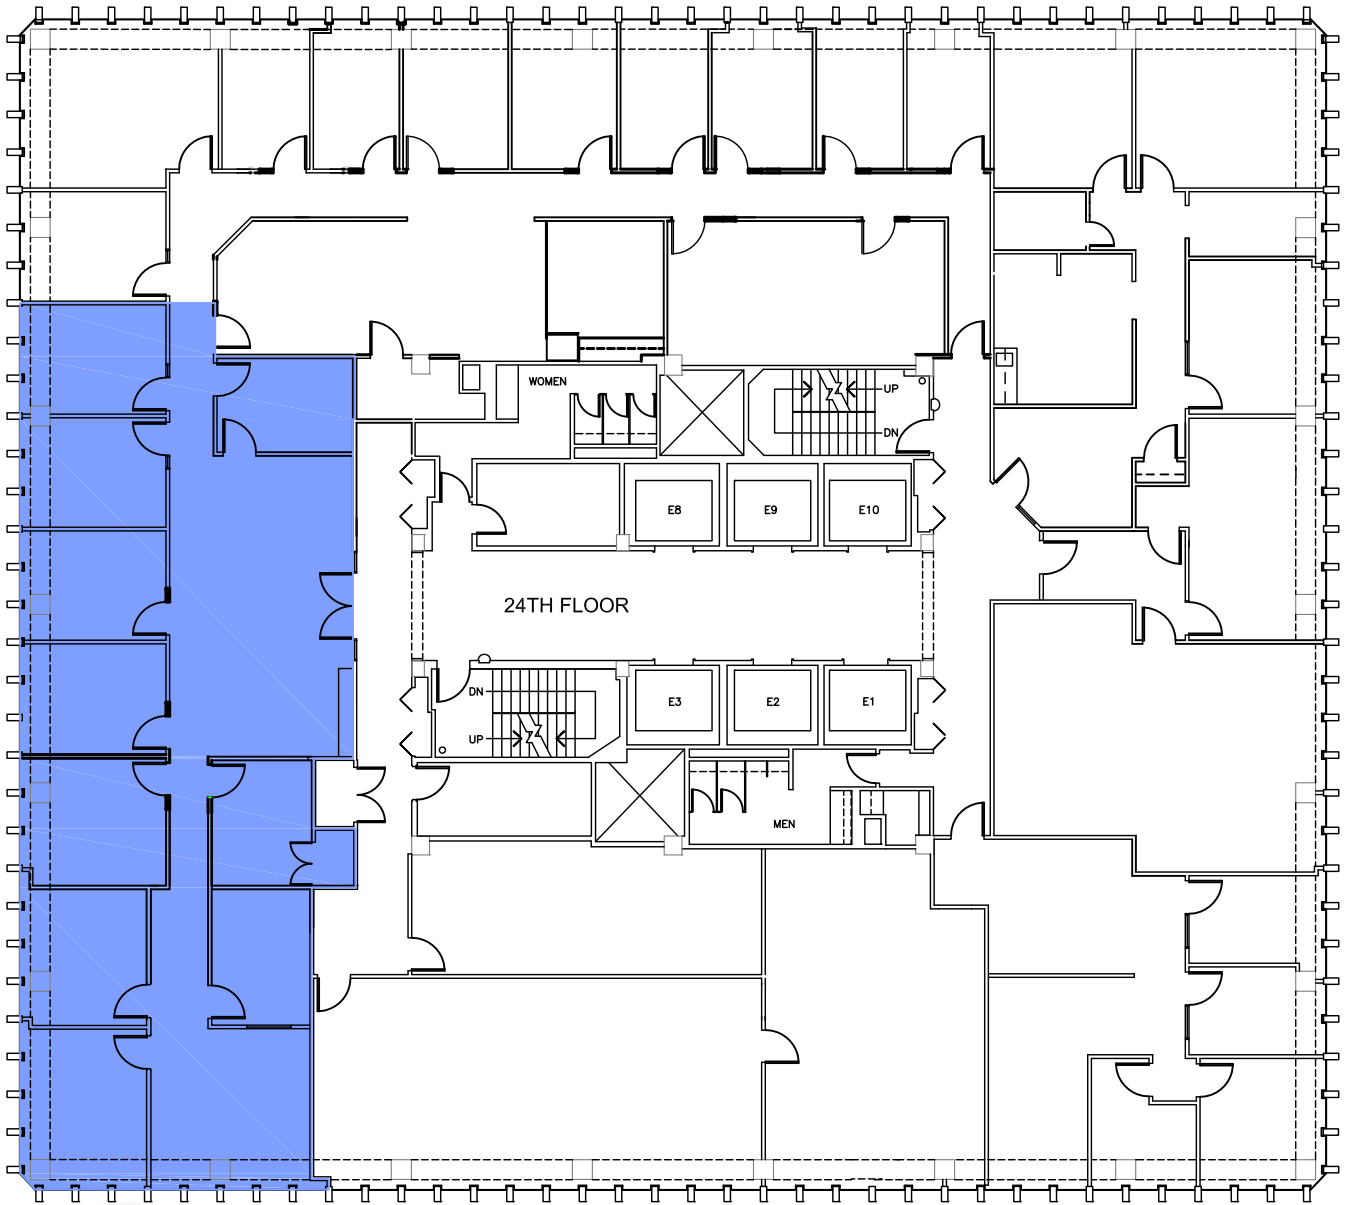