


#1710
AVAILABLE
1715 USF
1977 RSF

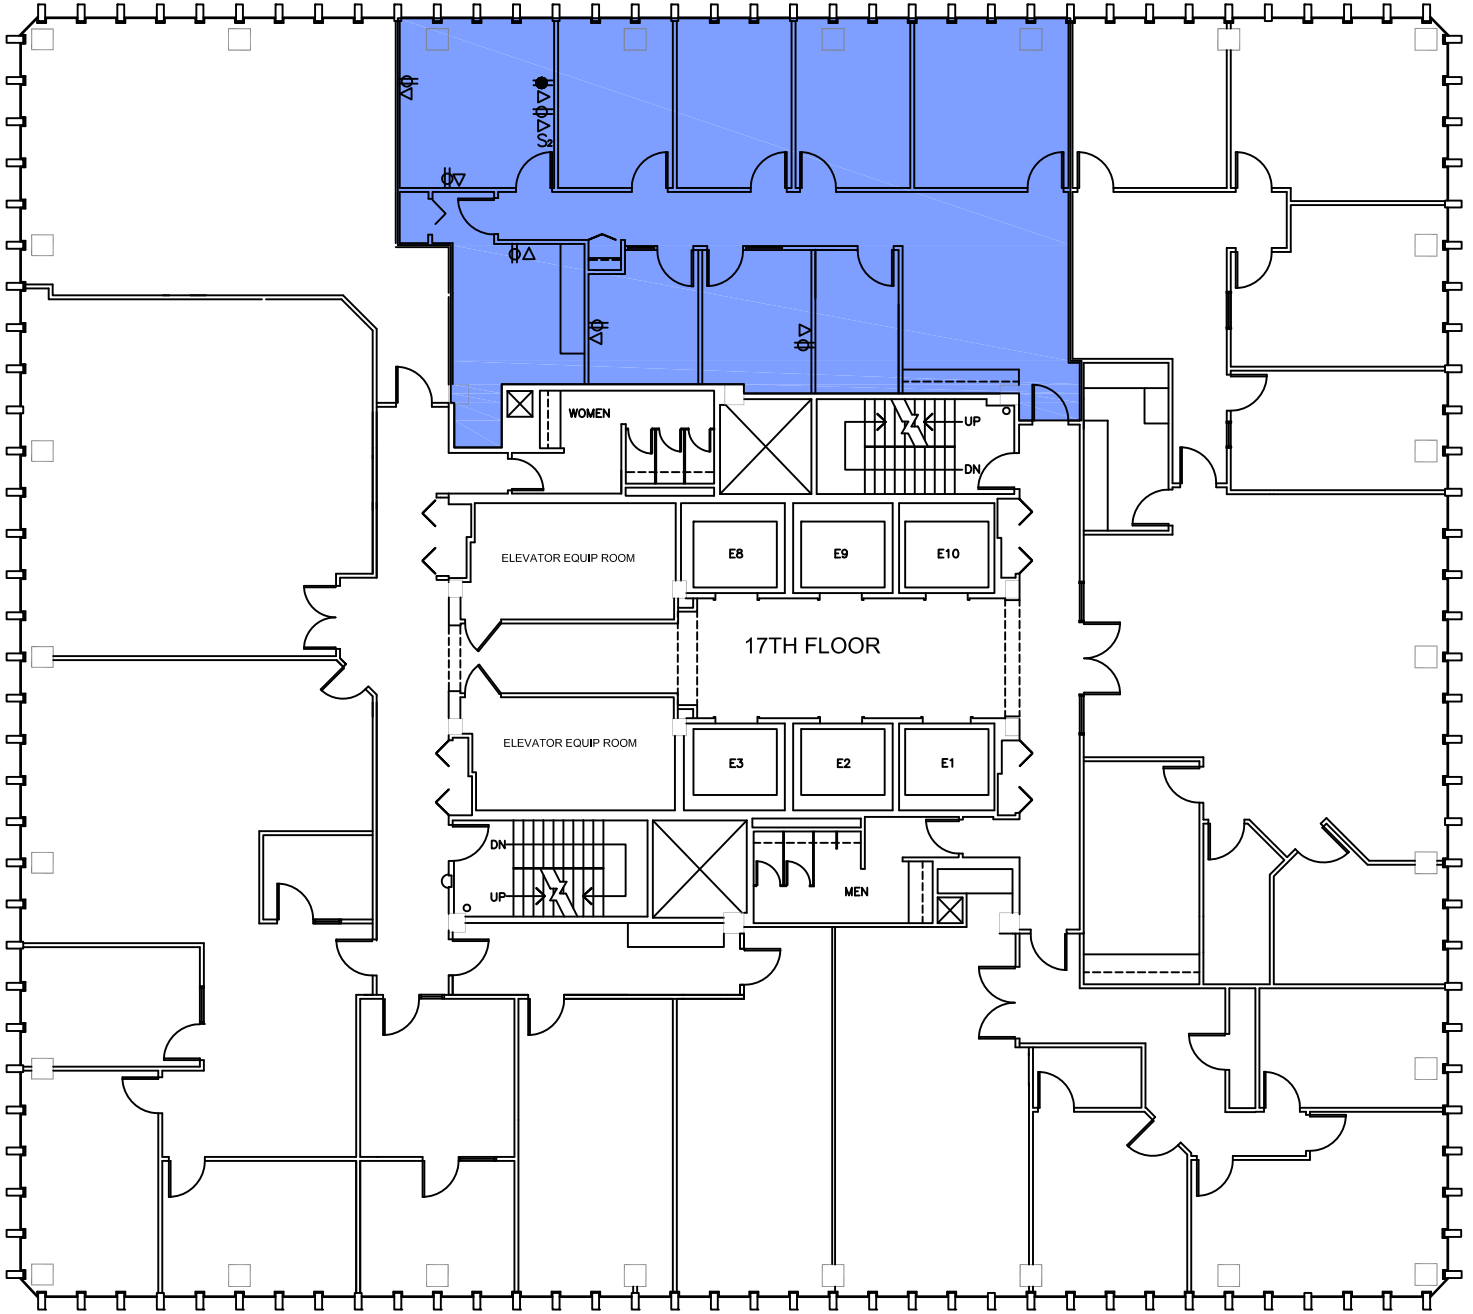

17th FLOOR

AS-BUILT FLOOR PLAN

NOT TO SCALE



THE WESTIN BUILDING
2001 SIXTH LLC

