


2009 FIFTH AVENUE
AVAILABLE
608 USF



THE WESTIN BUILDING
2001 SIXTH LLC

GARAGE LEVEL 1
AS-BUILT FLOOR PLAN
NOT TO SCALE

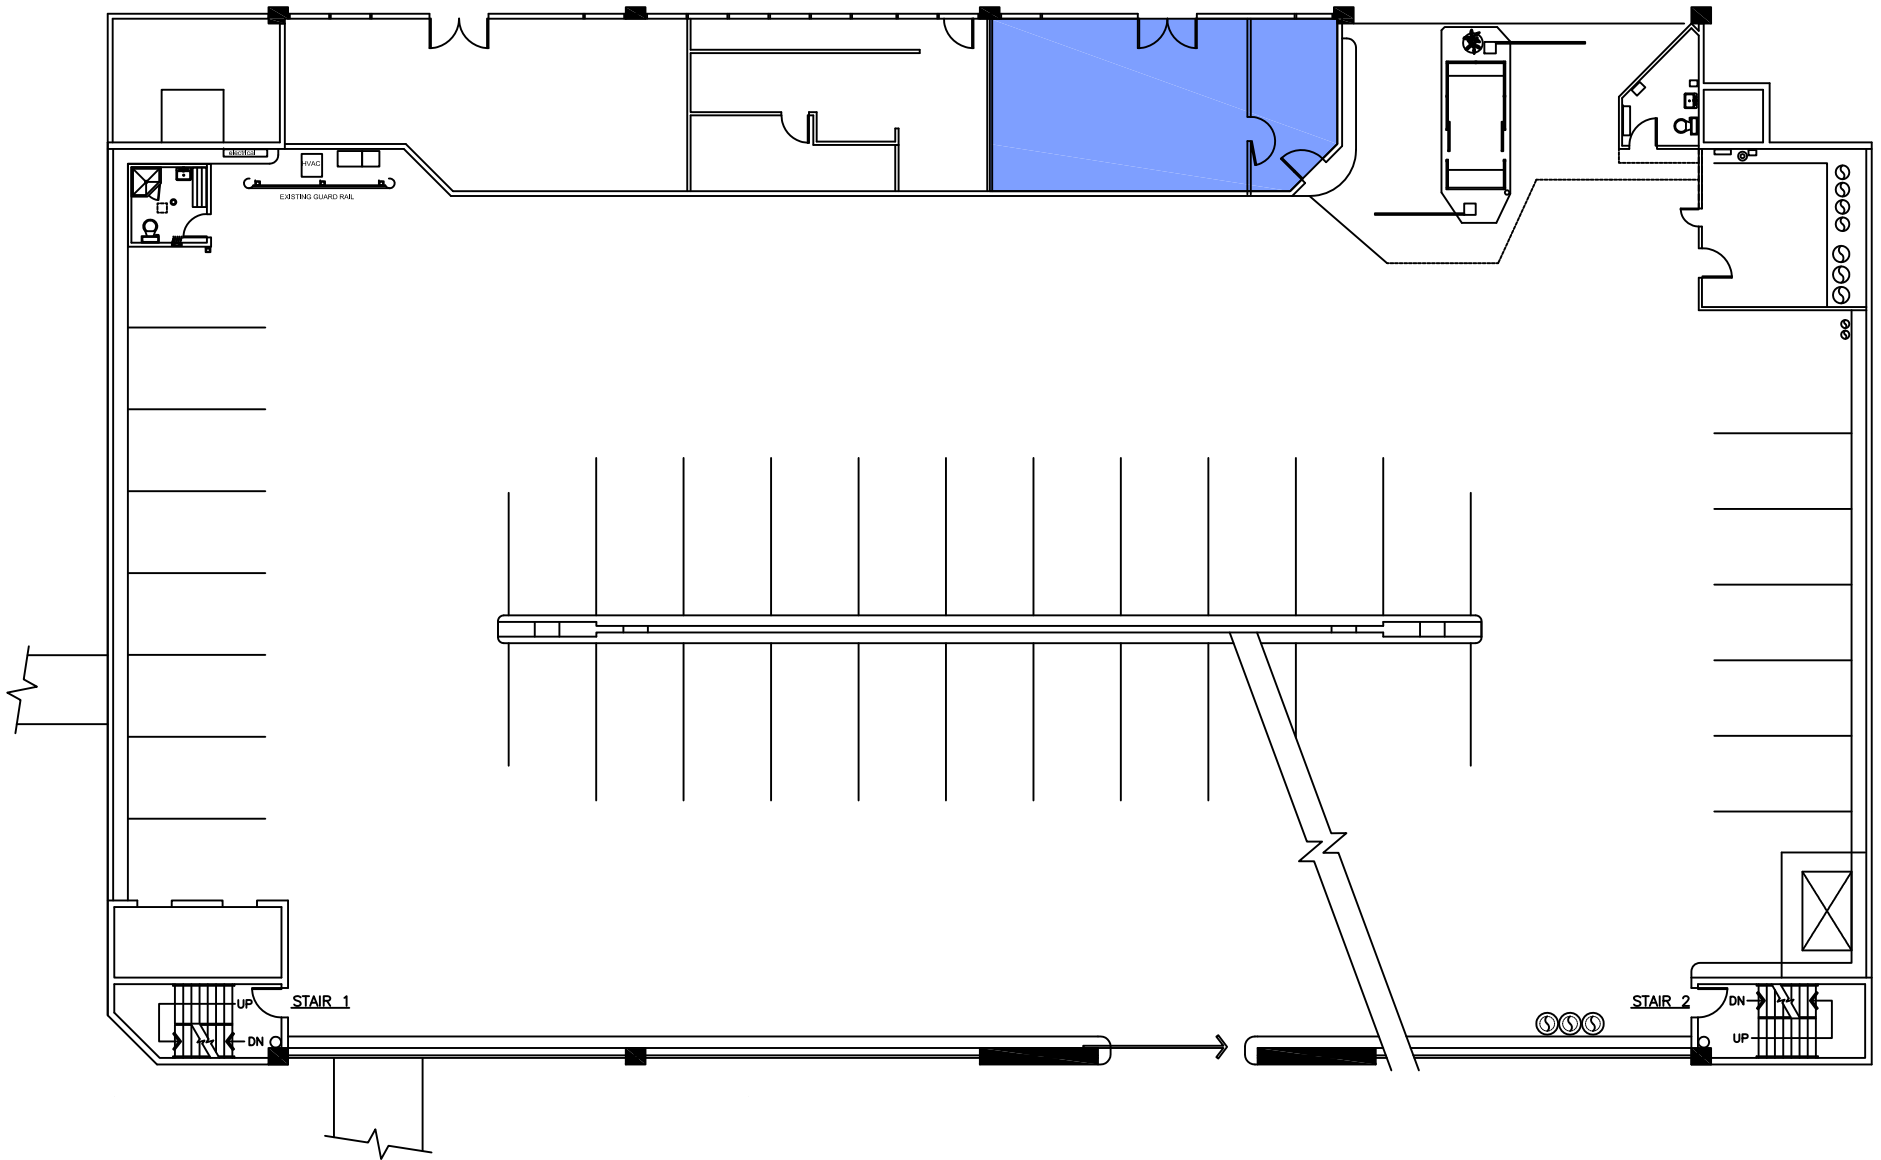