


#2717
AVAILABLE
5493 USF
6344 RSF

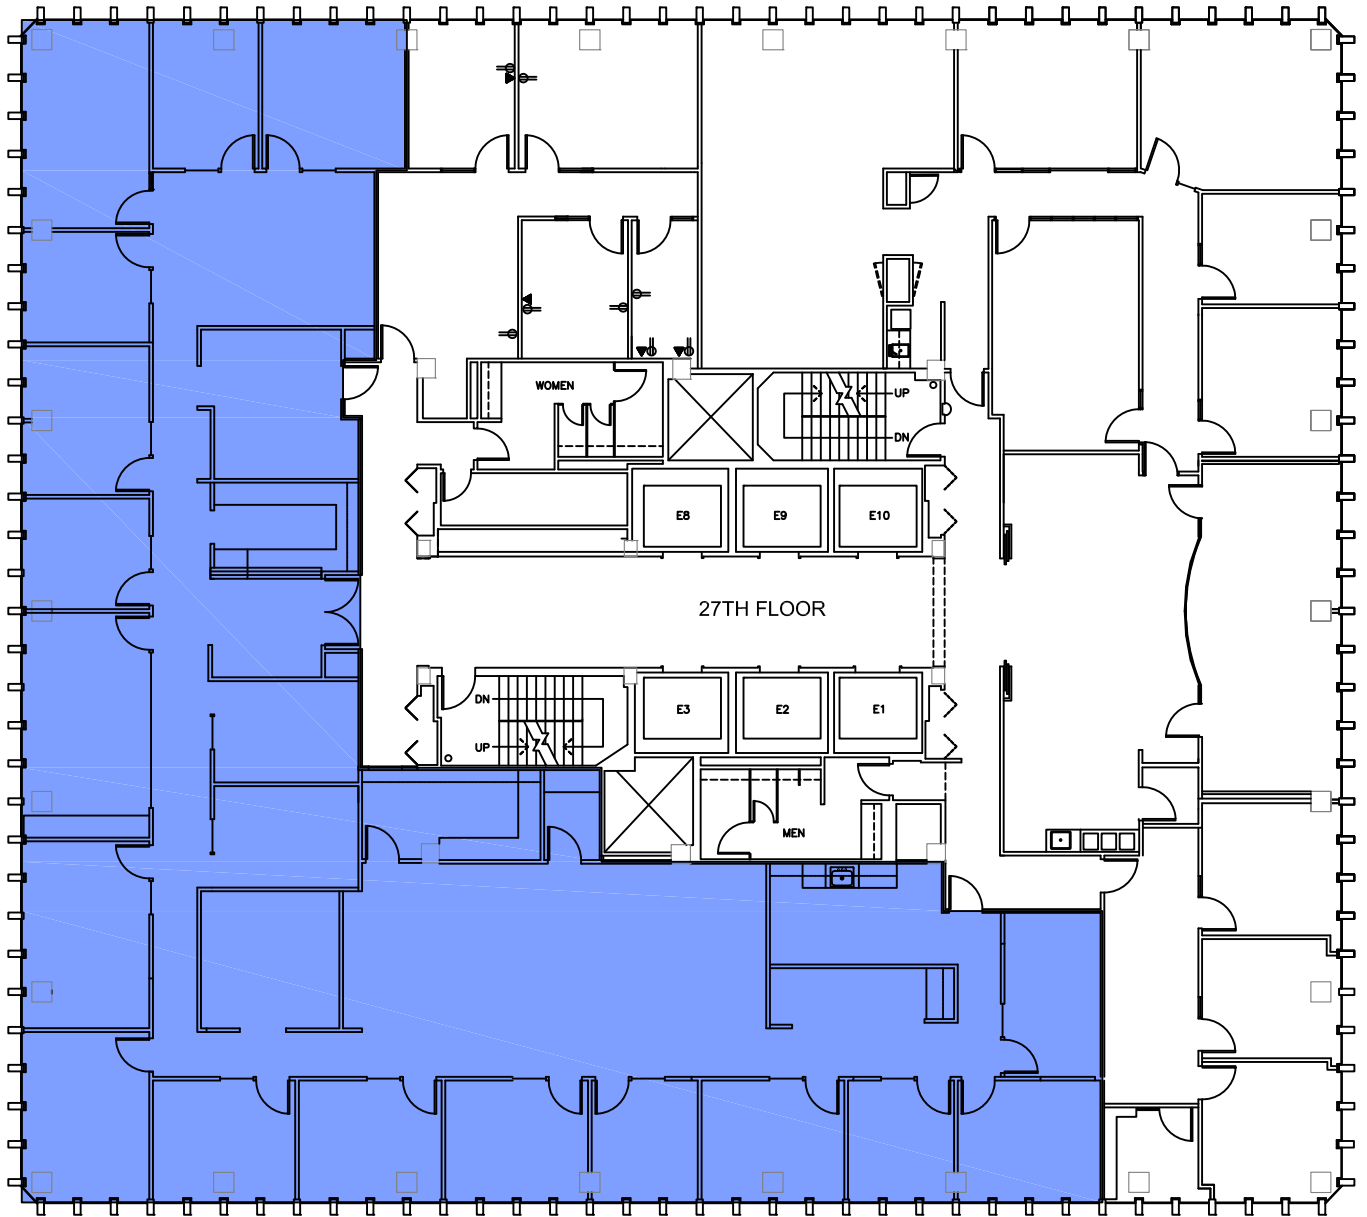

THE WESTIN BUILDING
2001 SIXTH LLC

27th FLOOR
AS-BUILT FLOOR PLAN
NOT TO SCALE

